December 2, 2016

San Francisco Bay Conservation and Development Commission
455 Golden Gate Ave. Suite 10600
San Francisco, CA 94102

Re: Live Aboard Report 2016/17

Attached please find a map showing the placement of our current live aboards. We currently have 33 liveaboards, which is 7.93% of the 416 slips throughout our Marina.

Dock A has 1 live aboard (Slip A21/23 – a catamaran slip)
Dock B has 5 live aboards (Slips B 7, 10, 16, 17, 28)
Dock C has 4 live aboards (Slips C 12, 22, 27, 33)
Dock D has 6 live aboards (Slips D 16, 29, 35, 36, 43, 52)
Dock E has 6 live aboards (Slips E 4, 23, 29, 48, 54 & E- End Tie)
Dock F has 3 live aboards (Slips F 2, 17, 53)
Dock G has 3 live aboards (Slips 8, 12, 48)
Dock H has 5 live aboards (Slips 11, 12, 18, 20, 37)

Mark Sanders
Westpoint Harbor

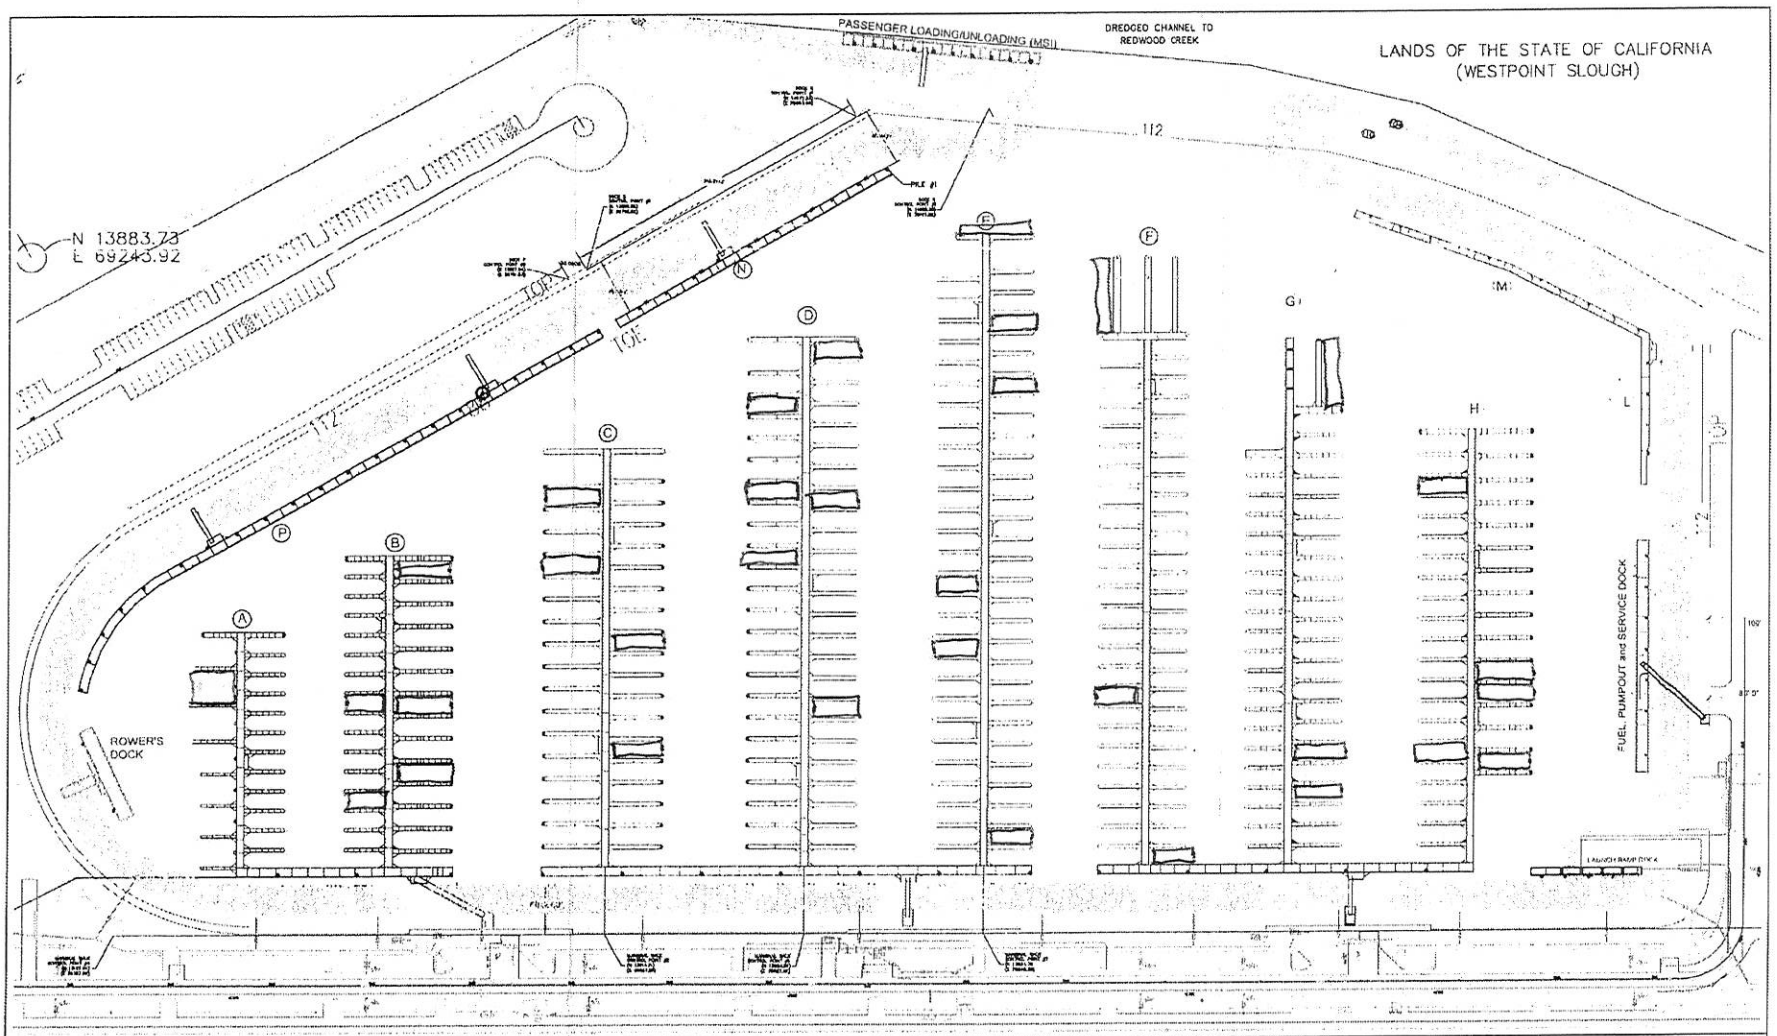

NO.	DATE	DESCRIPTION	BY

REVISIONS

Project Number: 06-3-442

PROJECT MANAGER -

Westpoint Marina
Redwood City, Ca.

Live Aboards - 12/2016

Bellingham MARINE — UNIFLOAT

Master AS-BUILT Layout (9-30-14)

SCALE: As Noted
DRAWN BY: D. DeCuire
CHECKED BY: -
DESIGNED/DESIGNER: -
SHEET: 1 of 1
Drawing Number: MPL1

City Of Redwood City

ACCEPTED BY: A.C.E. DP. DATE
ACCEPTED BY: CITY ENGINEER A.C.E. DP. DATE